


Wellsite As-Built Sketch - Production Phase

Well Name / Location	Anadarko Arrowhead I - 75
Grid Area	60 deg. 40 min 122 deg. 45 min
MVLWB: Permit No.	MV2002A0068 MV 2002L10012
Drwg By:	N Reynolds

130 m/Az 117

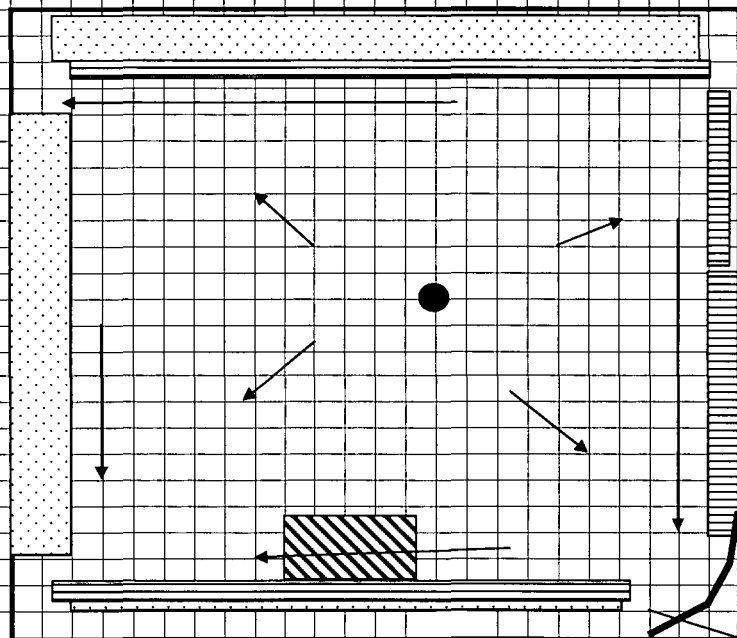

GENERAL NOTES

1. Pits A & B disposal by MBC as per Drilling Notification of Disposal Report.
2. Well Status Suspended Gas Well, c/w wellhead, no facilities.
3. Production pad constructed, 35 m radius. Strippings spread to pad perimeter and/or stockpiled.
4. Strippings treated with fertilizer 35-0-0 application. 140 kg/ha.
5. All brush disposal completed.
6. Drilling waste disposal at C-55 remote complete by MBC.
7. (a) draw with seasonal discharge, berm constructed on wellsite SE corner to deflect run-off around wellsite corner.
8. Surplus clean sawdust spread to site SW quadrant area.

(a)

Access

LEGEND

Brush Pile		Cut/Fill Line		Sump	
Burning Site	BS	Trench		Invert Farm	
Flare Pit		Berm		Topsoil	
Wellcentre		Test Pit	TP 1	Subsoil	
Wellhead		MBC Area			
Geotextile		Drainage			
Subcut area					